

CONTRACT NO / TO NO: N62473-10-D-0808		PROJECT TITLE / LOCATION: Rad Remediation D-1, Phase II / HPNS		ITSI GILBANE PROJECT NO: 07204.0004	
Survey No.: 07204.0004-1005-INF		Date: 7/17/2014		Location: HPNS	
Chris Robbins				Ed Palser	
Tech Printed Name		Signature		RSO Printed Name	
				Signature	

Instrument(s)

Model	Serial	Cal Due Date	Probe Model	Probe Serial	Cal Due Date	BKG α	BKG β	BKG γ	BKG μr/Hr	Eff. α	Eff. β
19	36519	12/26/2014	N/A						5.1	N/A	
N/A											
N/A											

Survey Description / Map /Photo

Survey Unit

J

Trench #:

04-PDT-010

Soil Survey Units

D0021	Jericho	Stockpile	N/A	N/A
D0023	N/A			N/A

(D0001 to D0042)

From the Bottom of Trench

Soil Compaction Lift From
Soil Compaction Lift From
0	ft to	1
1	ft to	2
2	ft to	3
3	ft to	4
4	ft to	5
5	ft to	6
6	ft to	7
7	ft to	8
8	ft to	9
9	ft to	10
10	ft to	11

μR/Hr μR/Hr μR/Hr μR/Hr

7	7	6	6
6	7	6	6
7	6	7	6
6	5	5	6
5	5	6	5
N/A	N/A	N/A	N/A
↓	↓	↓	↓

Comments: Informational Survey During Backfill Operation. Dose rates taken at 1 meter above surface to support RESRAD model. Model 19 BKGD from taken from instrument set up sheet.



Sheet
reference
number:

1 of 2


VERIFY SCALE
BAR IS OVER ENOUGH
ORIGINAL DRAWINGS
TO BE USED FOR
IF NOT ONE INCH ON
THIS SHEET, ADJUST
SCALE ACCORDINGLY

RADIOLOGICAL REMEDIATION AND SUPPORT
PARCEL D-1, PHASE II
HUNTERS POINT NAVAL SHIPYARD
SAN FRANCISCO, CALIFORNIA

AS-BUILT PLANS
DECEMBER 2013

TRENCH EXCAVATION
LAYOUT PLAN

TSI Gilbane
2730 Shadelands Drive
Walnut Creek, CA 94598

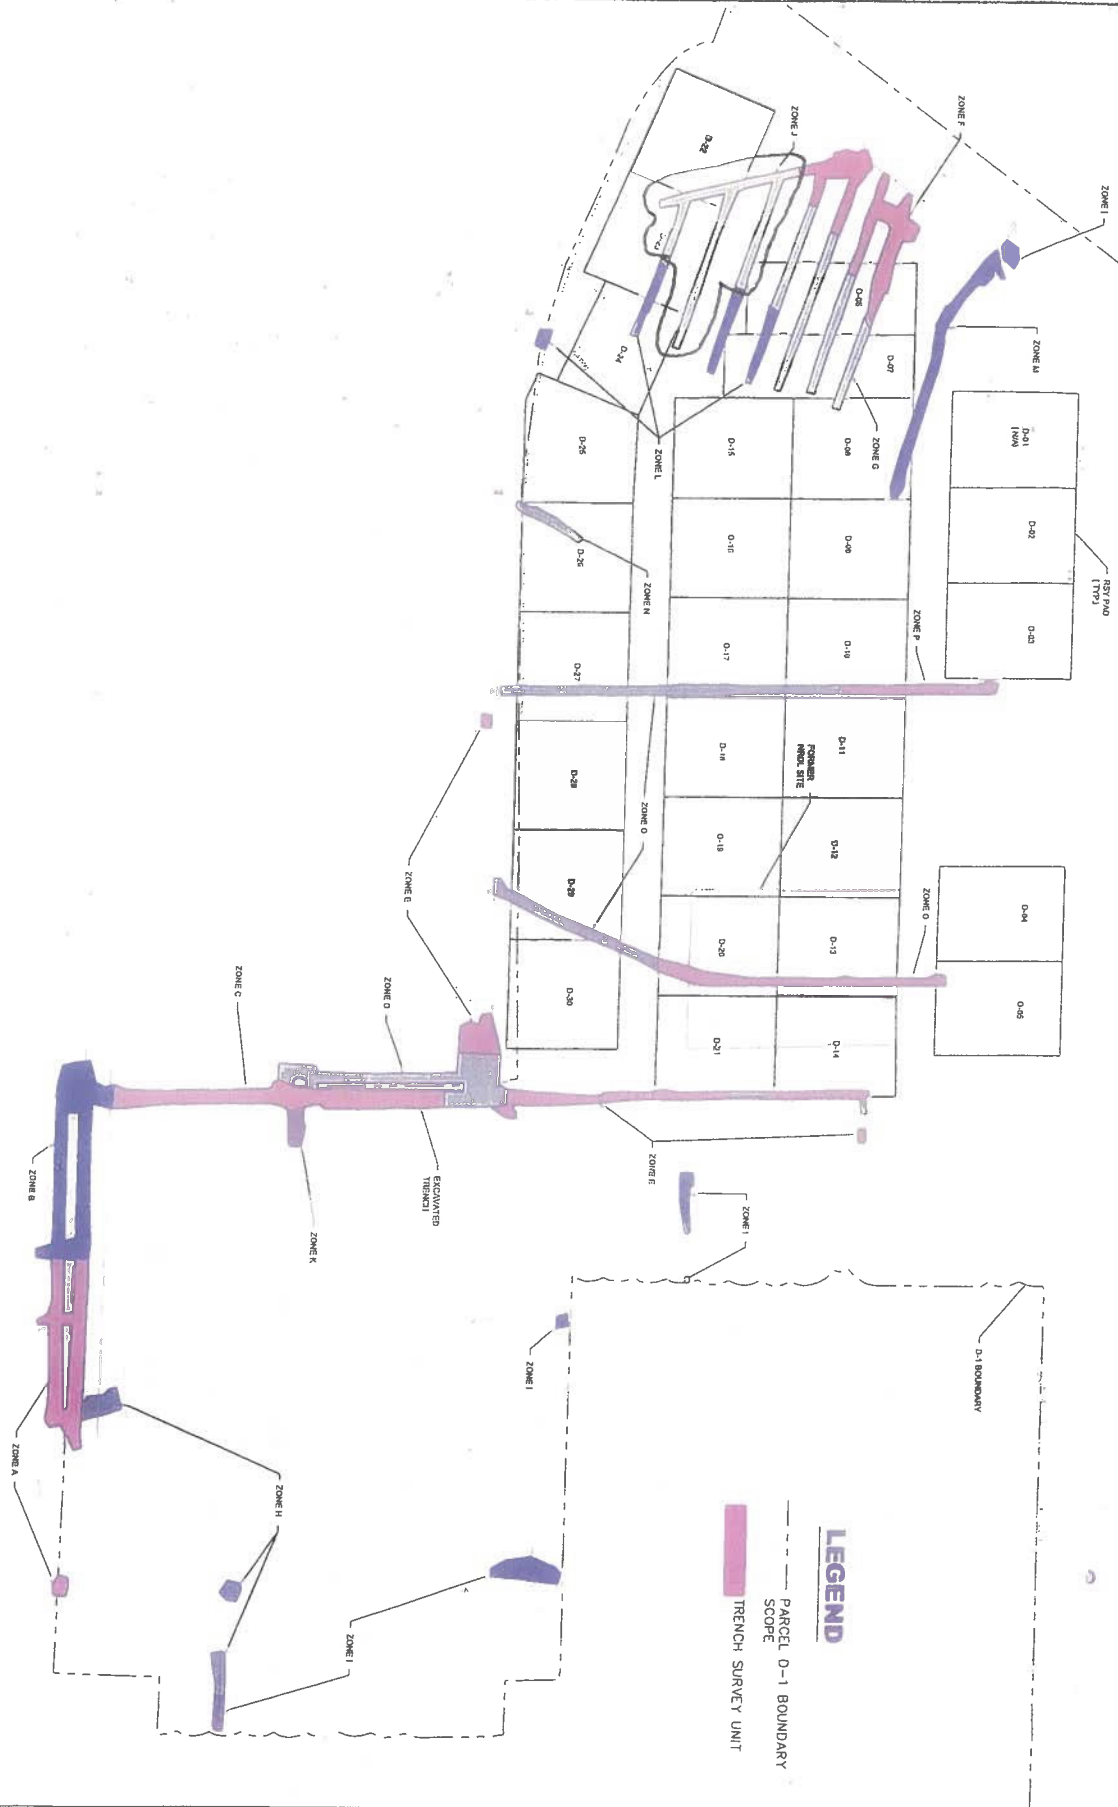

LEGEND
--- PARCEL D-1 BOUNDARY
--- SCOPE
█ TRENCH SURVEY UNIT

Revised
2/9
8/1/14